


Second Dry Creek Crossing

August 1982

This sheet was found in project folder. Construction plans have not been located for this project.

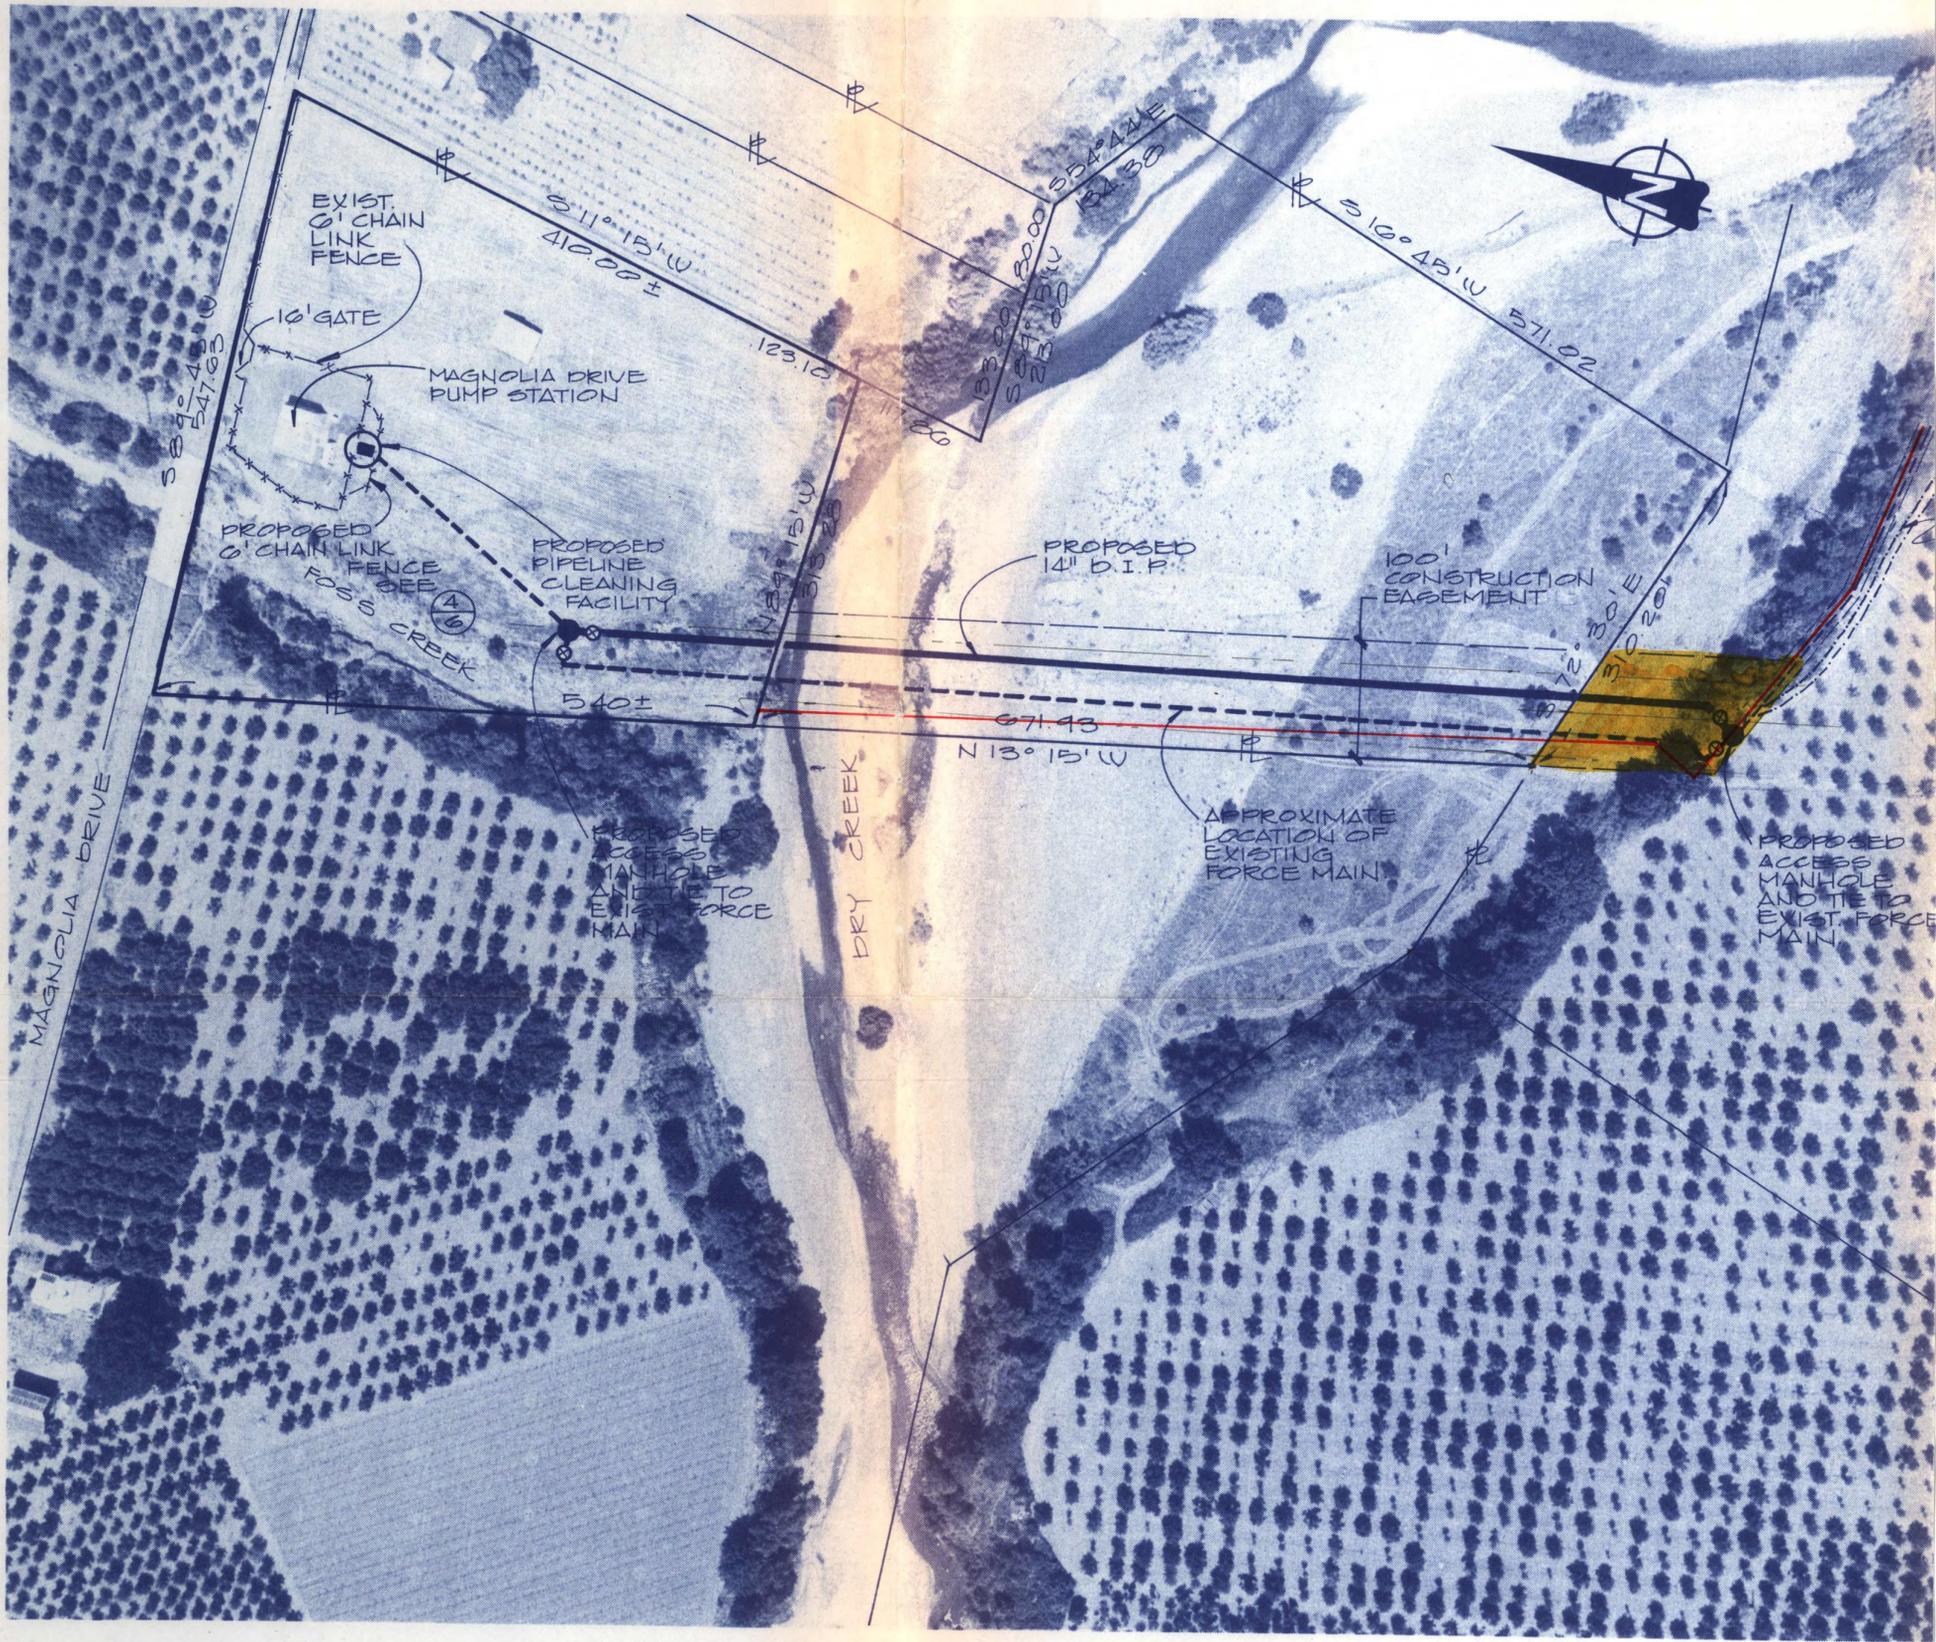

SITE LOCATION MAP

SCALE: 1"=100'

LEGEND

- CITY OF HEALDSBURG PROPERTY
- OTHER PROPERTY LINES
- CONSTRUCTION EASEMENT
- PROPOSED 14" SEWER FORCE MAIN
- PROPOSED ACCESS MANHOLE
- PROPOSED 14" GATE VALVE
- PIPELINE CLEANING FACILITY
- EXISTING 14" SEWER FORCE MAIN
- FENCE LINE
- ACCESS ROAD

SECOND DRY CREEK FORCE MAIN CROSSING
 SEPTEMBER 3, 1982 2:00 p.m.

ITEM NO.	DESCRIPTION	UNITS	NO. UNITS	HUFFMAN CONST.		ARGONAUT		SOILAND		NORTH BAY CONST.		MGM CONST.	
				UNIT COST	TOTAL	UNIT COST	TOTAL	UNIT COST	TOTAL	UNIT COST	TOTAL	UNIT COST	TOTAL
1	14" Ductile Iron Force Main	Lin. Ft.	1,026	\$ 32.	\$32,832.	\$ 37.	\$37,962.	\$ 56.	\$57,456.	\$ 63.	\$64,630.	\$ 122.	\$125,172.
2	14" Gate Valves	each	4	2,100.	8,400.	2,775.	11,100.	1,750.	7,000.	2,650.	10,600.	2,675.	10,700.
3	Erosion Control	Lump Sum		3,050.	3,050.	2,200.	2,200.	2,300.	2,300.	6,900.	6,900.	4,000.	4,000.
4	Tie In	Lump Sum		6,790.	6,790.	6,200.	6,200.	2,400.	2,400.	5,500.	5,500.	12,000.	12,000.
5	Mobilization & Demobilization	Lump Sum		3,000.	3,000.	1,300.	1,300.	780.	780.	4,500.	4,500.	10,000.	10,000.
TOTAL BASE BID					\$54,072.		\$58,762.		\$69,936.		\$92,138.		\$161,872.
ALTERNATIVE A													
1A	Access Port Installation	each	4	\$1,150.	\$ 4,600.	\$ 900.	\$ 3,600.	\$ 975.	\$ 3,900.	\$1,300.	\$ 5,200.	\$ 1,500.	\$ 6,000.
TOTAL BID ALTERNATIVE A					\$58,672.		\$62,362.		\$73,836.		\$97,338.		\$167,872.
ALTERNATIVE B													
1B	Pipeline Cleaning Facility	Lump Sum		\$16,292.	\$16,292.	\$13,243.	\$13,243.	\$16,500.	\$16,500.	\$15,250.	\$15,250.	\$16,800.	\$16,800.
TOTAL BID ALTERNATIVE B					\$70,364.		\$72,005.		\$86,436.		\$107,388.		\$178,672.

CITY OF HEALDSBURG
CHANGE ORDER

Order No. One

Date: November 24, 1982

Agreement Date: September 17, 1982

NAME OF PROJECT Second Dry Creek Force Main Crossing

CONTRACTOR: Huffman Construction, Inc.

The following changes are hereby made to the CONTRACT DOCUMENTS:

Revision of the design of B/4 pipeline cleaning station and of D/4 support and slab detail dated 10/11/82 as shown on sheet 4 of 6 of the project plans:

Change to CONTRACT PRICE:

Original CONTRACT PRICE \$ 70,364.00

Current CONTRACT PRICE adjusted by previous CHANGE ORDER \$ _____

The CONTRACT PRICE due to this CHANGE ORDER will be (increased) (~~decreased~~) by: \$ 2,487.00

The new CONTRACT PRICE due to this CHANGE ORDER will be \$ 72,851.00

Change to CONTRACT TIME:

The CONTRACT TIME will be (increased) (~~decreased~~) by 42 calendar days.

The date of completion of all work will be Thursday, 1/6/83 (date).
from Notice to Proceed

Richard J. Pusich
City Engineer



Bill Robertson
Engineering Technician

NOTICE OF RECEIPT

Receipt of the above Change Order No. _____
is hereby acknowledged by

(Name of Firm)

this the _____ day of _____,

By _____


Title _____

RECEIVED

FILE

NOV 24 '82

CITY OF HEALDSBURG
ENGINEERING

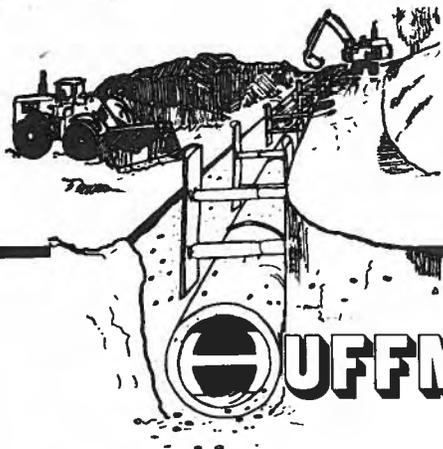

HUFFMAN CONSTRUCTION, INC.

GENERAL ENGINEERING

CLASS A 336858

P.O. BOX 158 • LAKEPORT, CALIFORNIA 95453 • PHONE (707) 279-8858

November 23, 1982

City of Healdsburg
126 Matheson Street
Healdsburg, CA 95448

Attention: Bill Robertson
Engineering Technician

RE: Second Dry Creek Crossing


Dear Bill,

Enclosed please find the proposal for the re-design pipe cleaning station for the Second Dry Creek Crossing in the amount of \$2,487.00.

Best Regards,

Charles Huffman
Huffman Construction, Inc.

CH/mgm

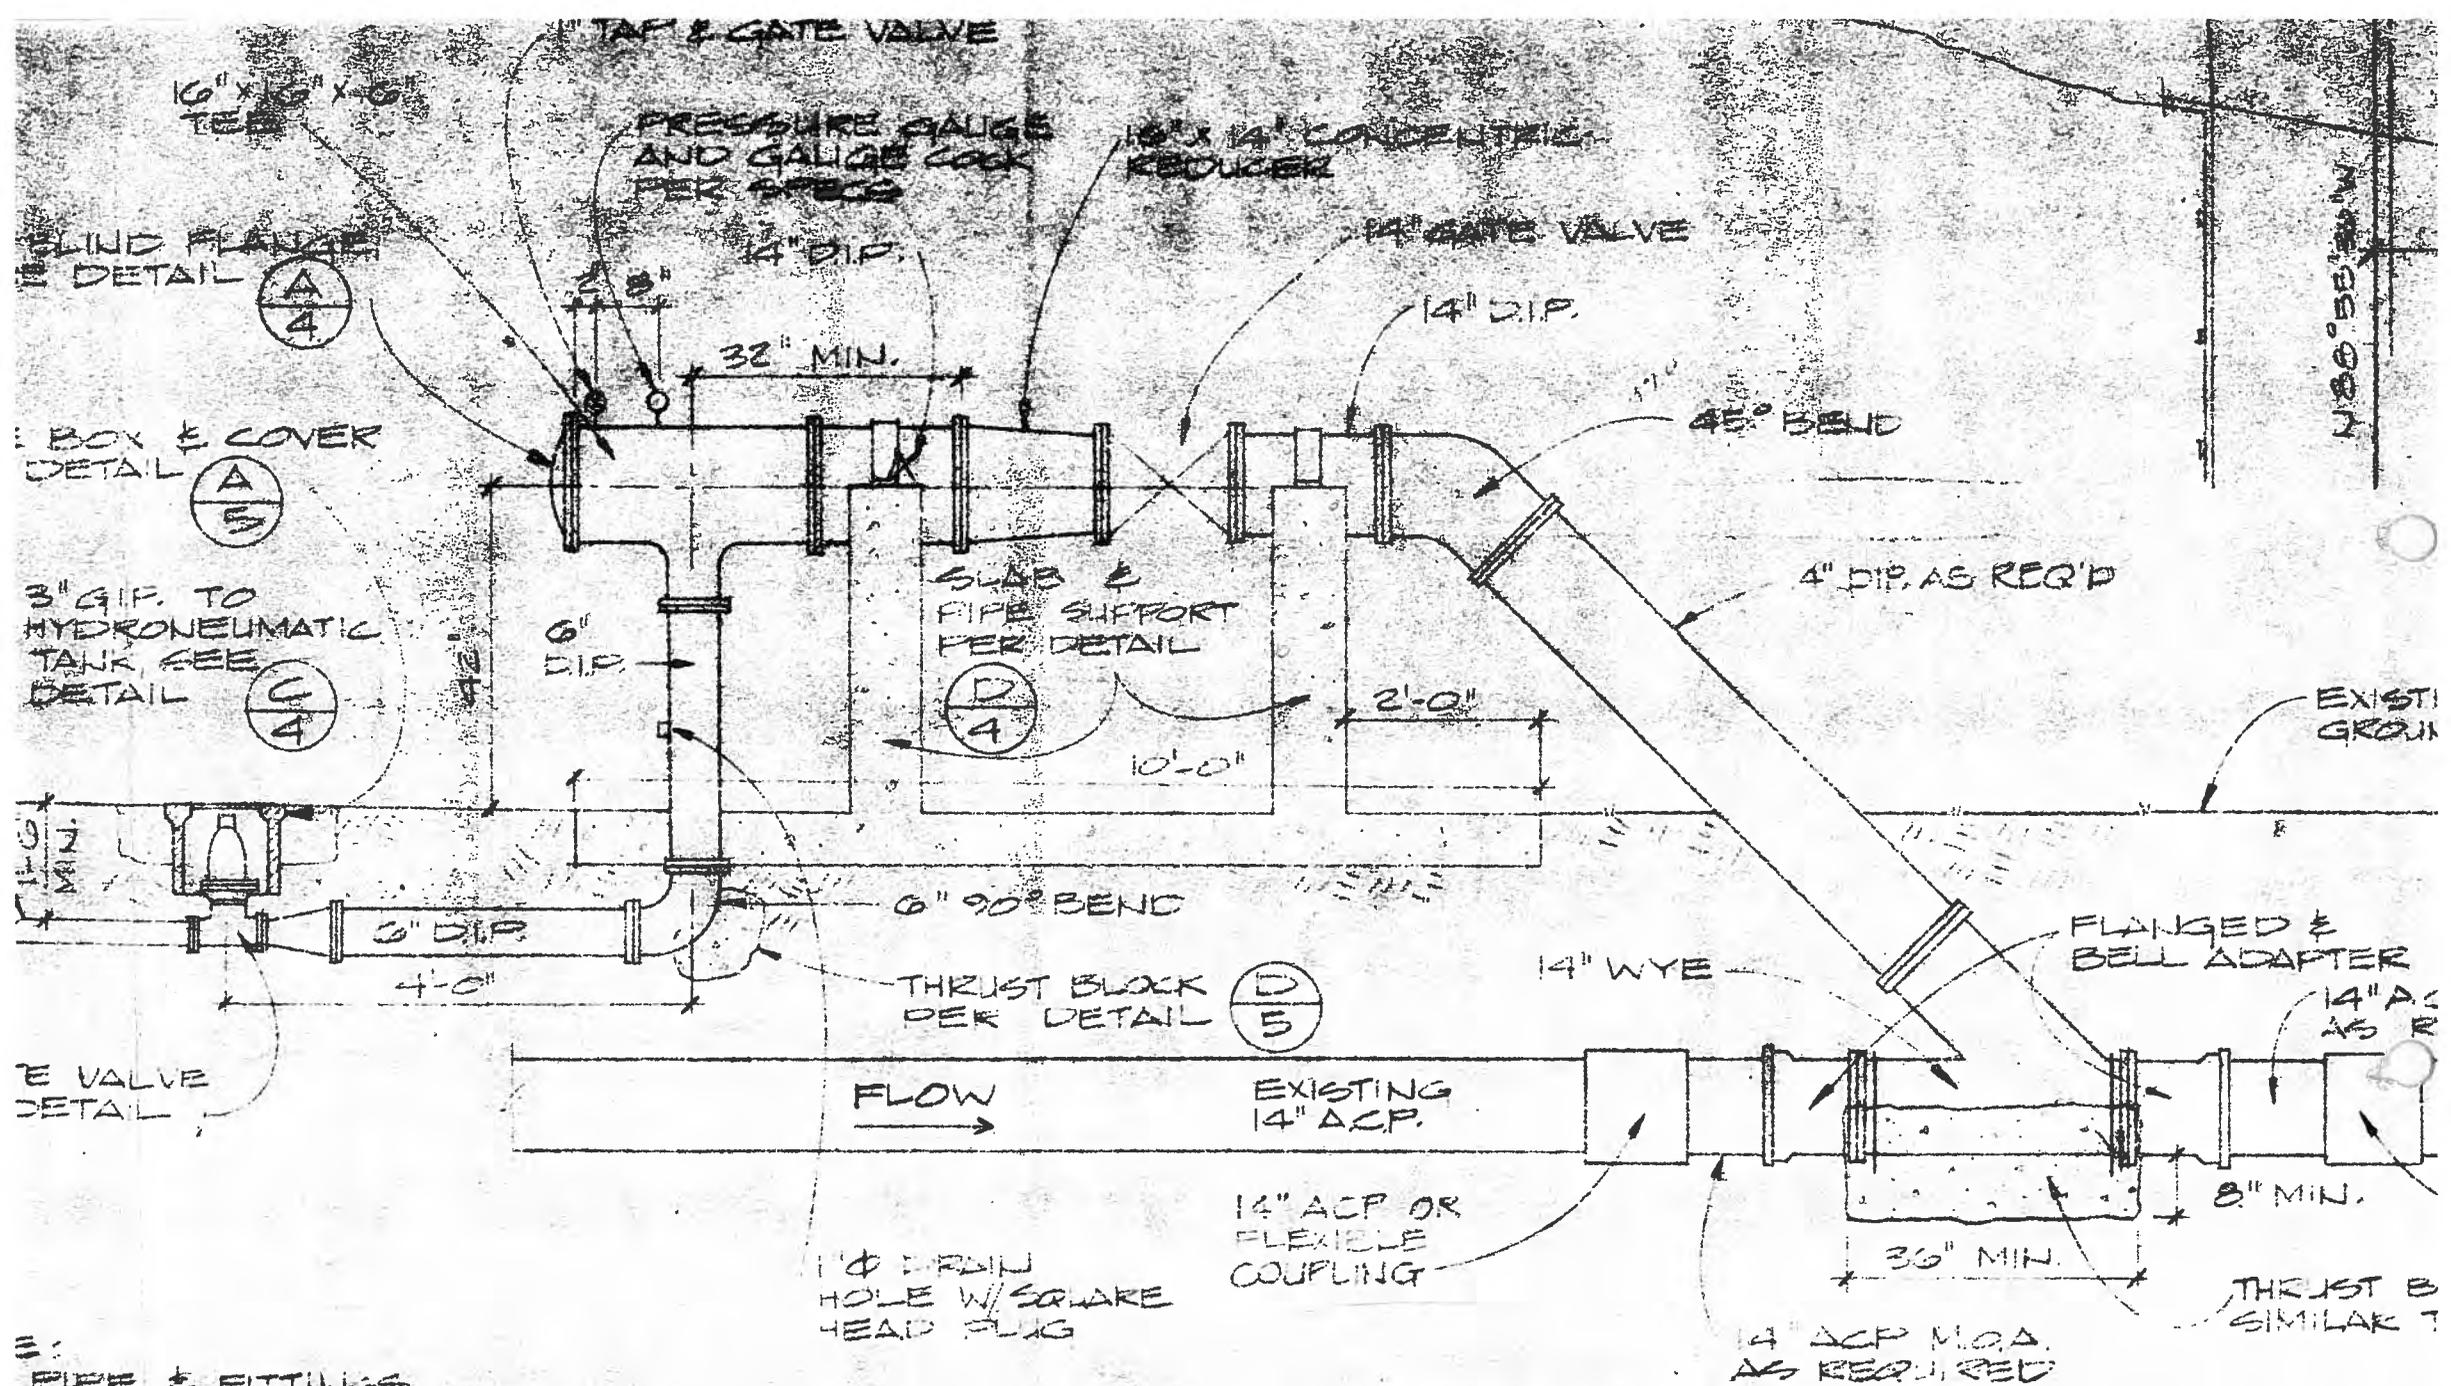

B: PIPE & FITTINGS
 C: DUCTILE IRON
 D: FLANGED CONNECTIONS
 E: OTHERWISE
 F: ID.

(B) (A) PIPE LINE CLEANING STATION