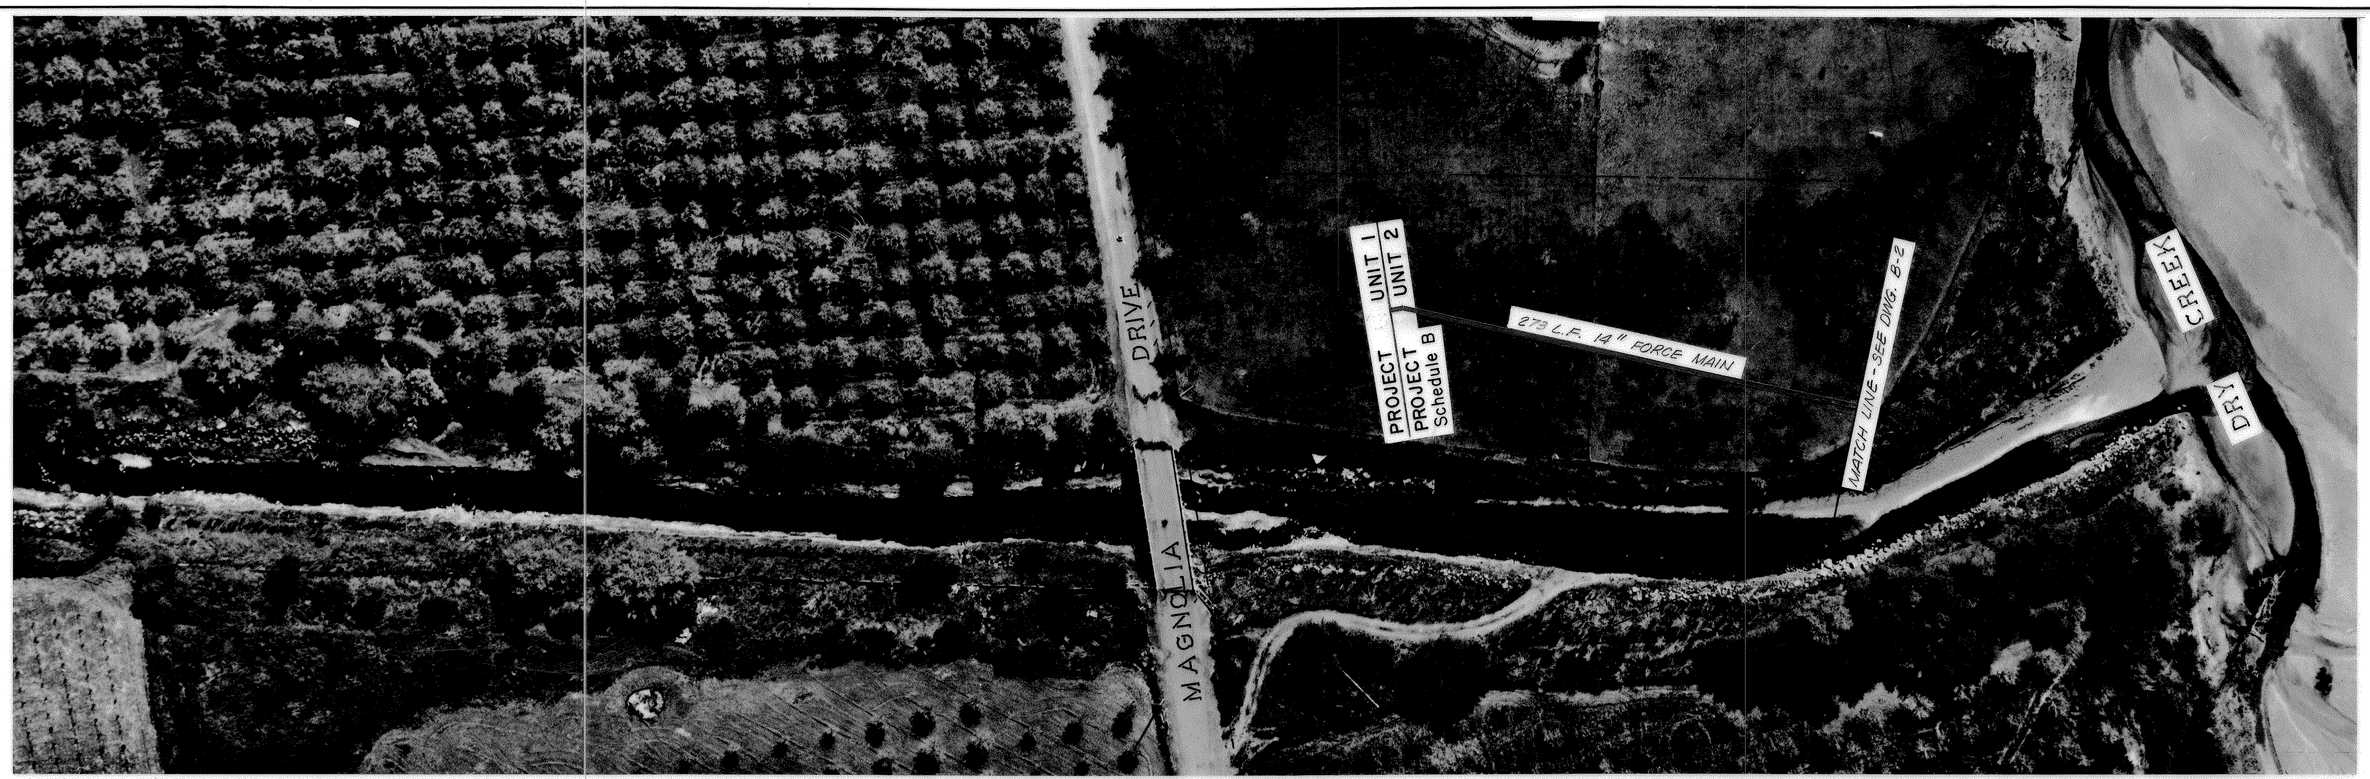

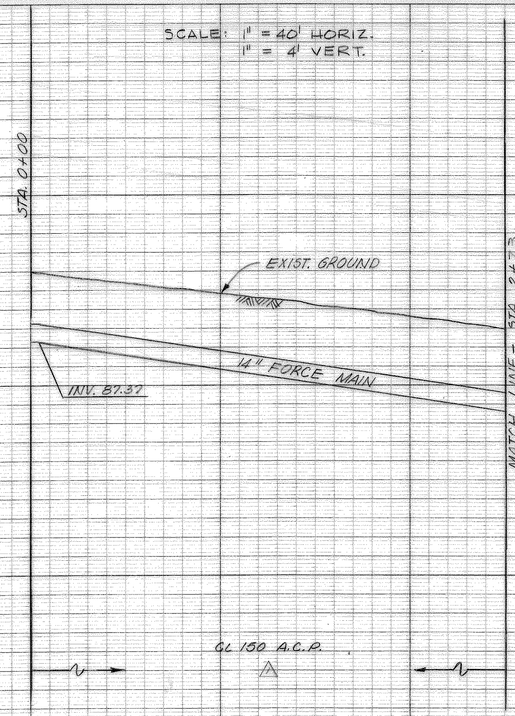

AS BUILT

NO.	REVISION	BY	DATE
2	AS BUILT	RE	4/72
1	ADDENDUM NO. 3	CM	5/70

YODER/ORLOB ASSOCIATES
CONSULTING ENGINEERS
WALNUT CREEK, CALIFORNIA

DESIGNED MEB
DRAWN DRL CHECKED E. M.
JOB. NO. 6305.2
DATE MARCH 1970

CITY OF HEALDSBURG, SONOMA COUNTY, CALIFORNIA

APPROVED Maurice E. Burchett Project Engineer
APPROVED R.P.E. CIVIL # 7023 For Yoder/Orlob Associates
APPROVED

WATER POLLUTION CONTROL FACILITIES
PROJECT UNIT 2 - SCHEDULE B

SANITARY FORCE MAIN
STA. 0+00 To STA. 2+50

DRAWING B-1

FILE No. D-

File No. CIP1970.02

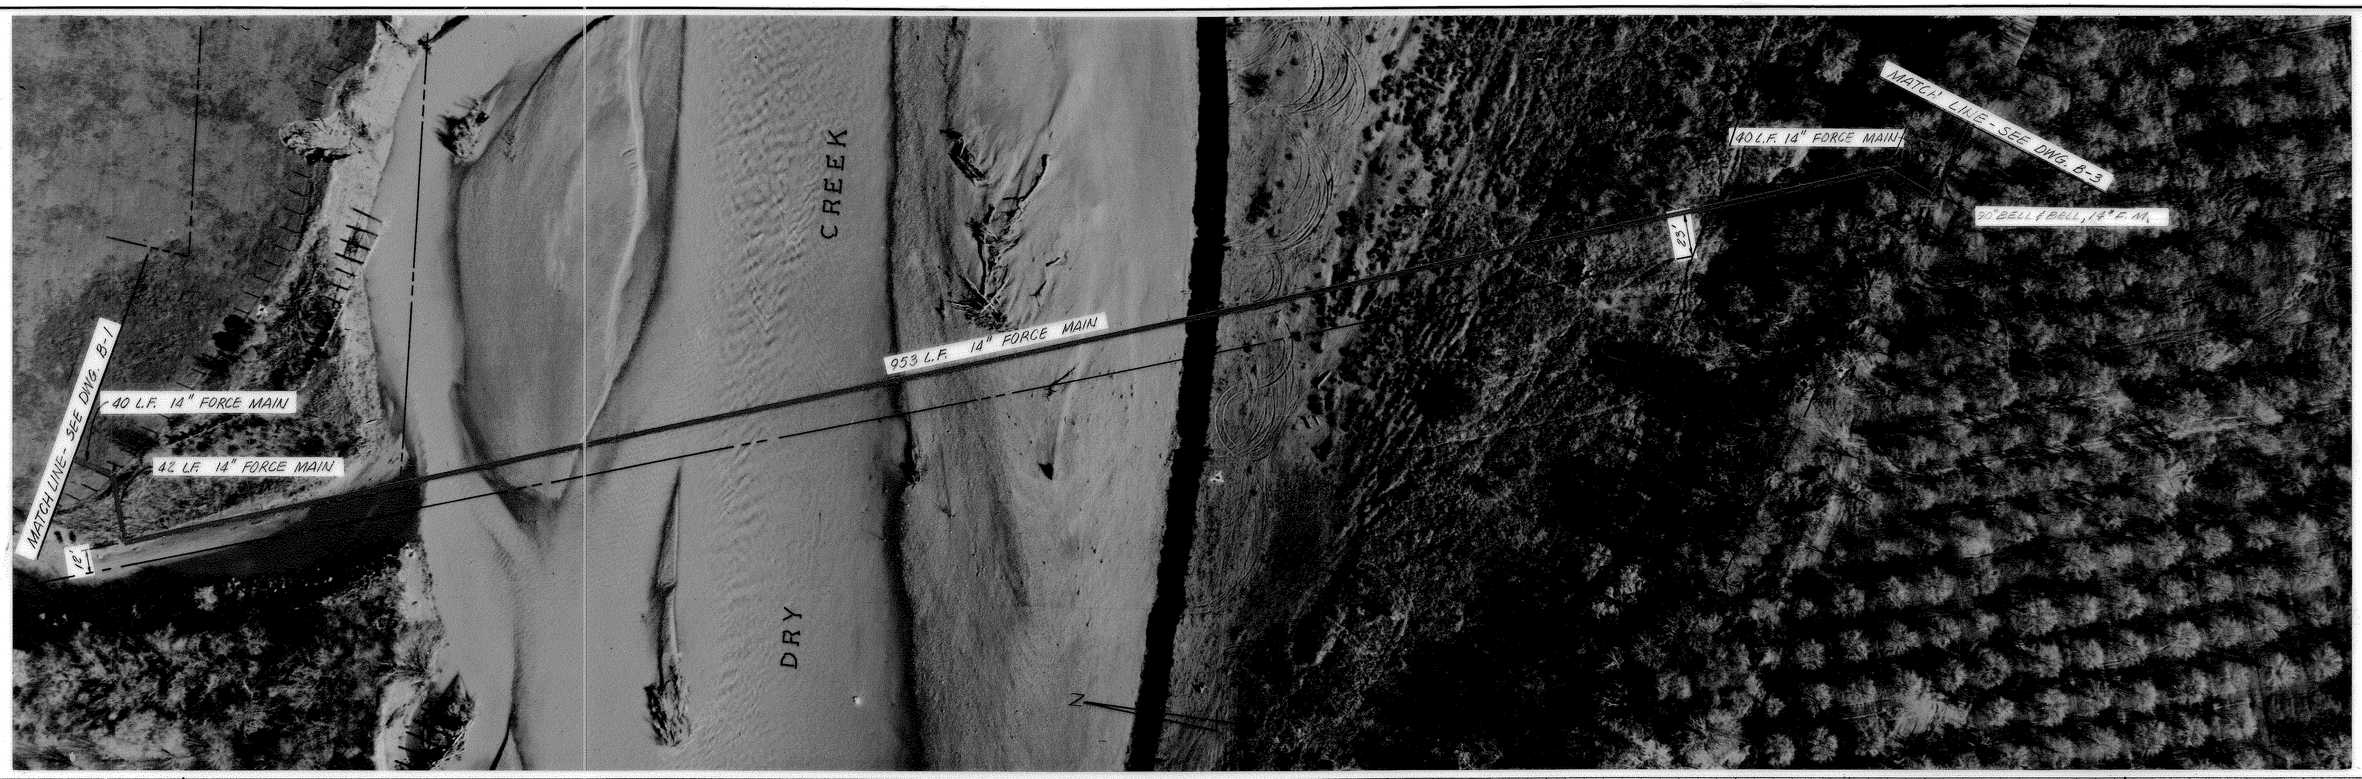

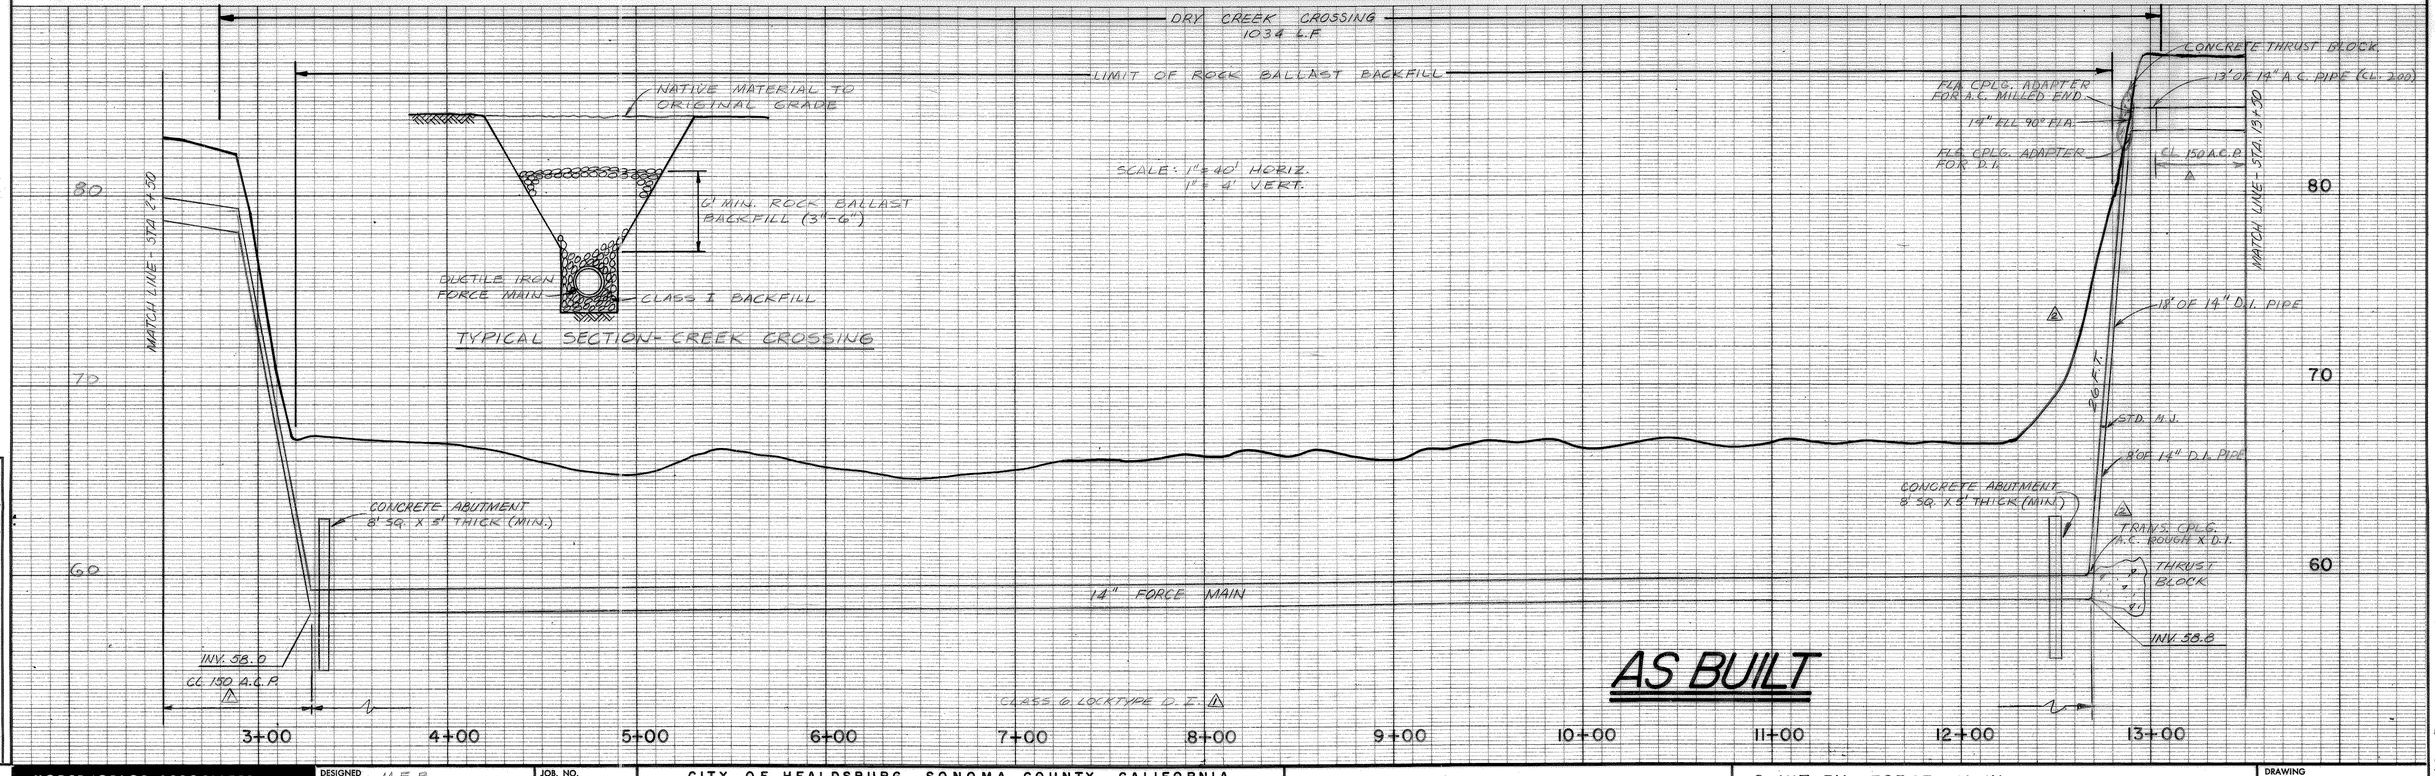

NO.	REVISION	BY	DATE
1	AS BUILT	RE	4/72
2	ADDENDUM NO. 3	EM	5/70

YODER/ORLOB ASSOCIATES
CONSULTING ENGINEERS
WALNUT CREEK, CALIFORNIA

DESIGNED MEB
DRAWN DRL
CHECKED E.M.
JOB NO. 6305.2
DATE MARCH 1970

CITY OF HEALDSBURG, SONOMA COUNTY, CALIFORNIA

APPROVED Project Engineer
APPROVED R.P.E. CIVIL # 7023 For Yoder/Orlob Associates
APPROVED

WATER POLLUTION CONTROL FACILITIES
PROJECT UNIT 2 - SCHEDULE B

SANITARY FORCE MAIN
STA. 2+50 To STA. 13+50

DRAWING B-2

FILE No. D-

File No. CIP1971.02

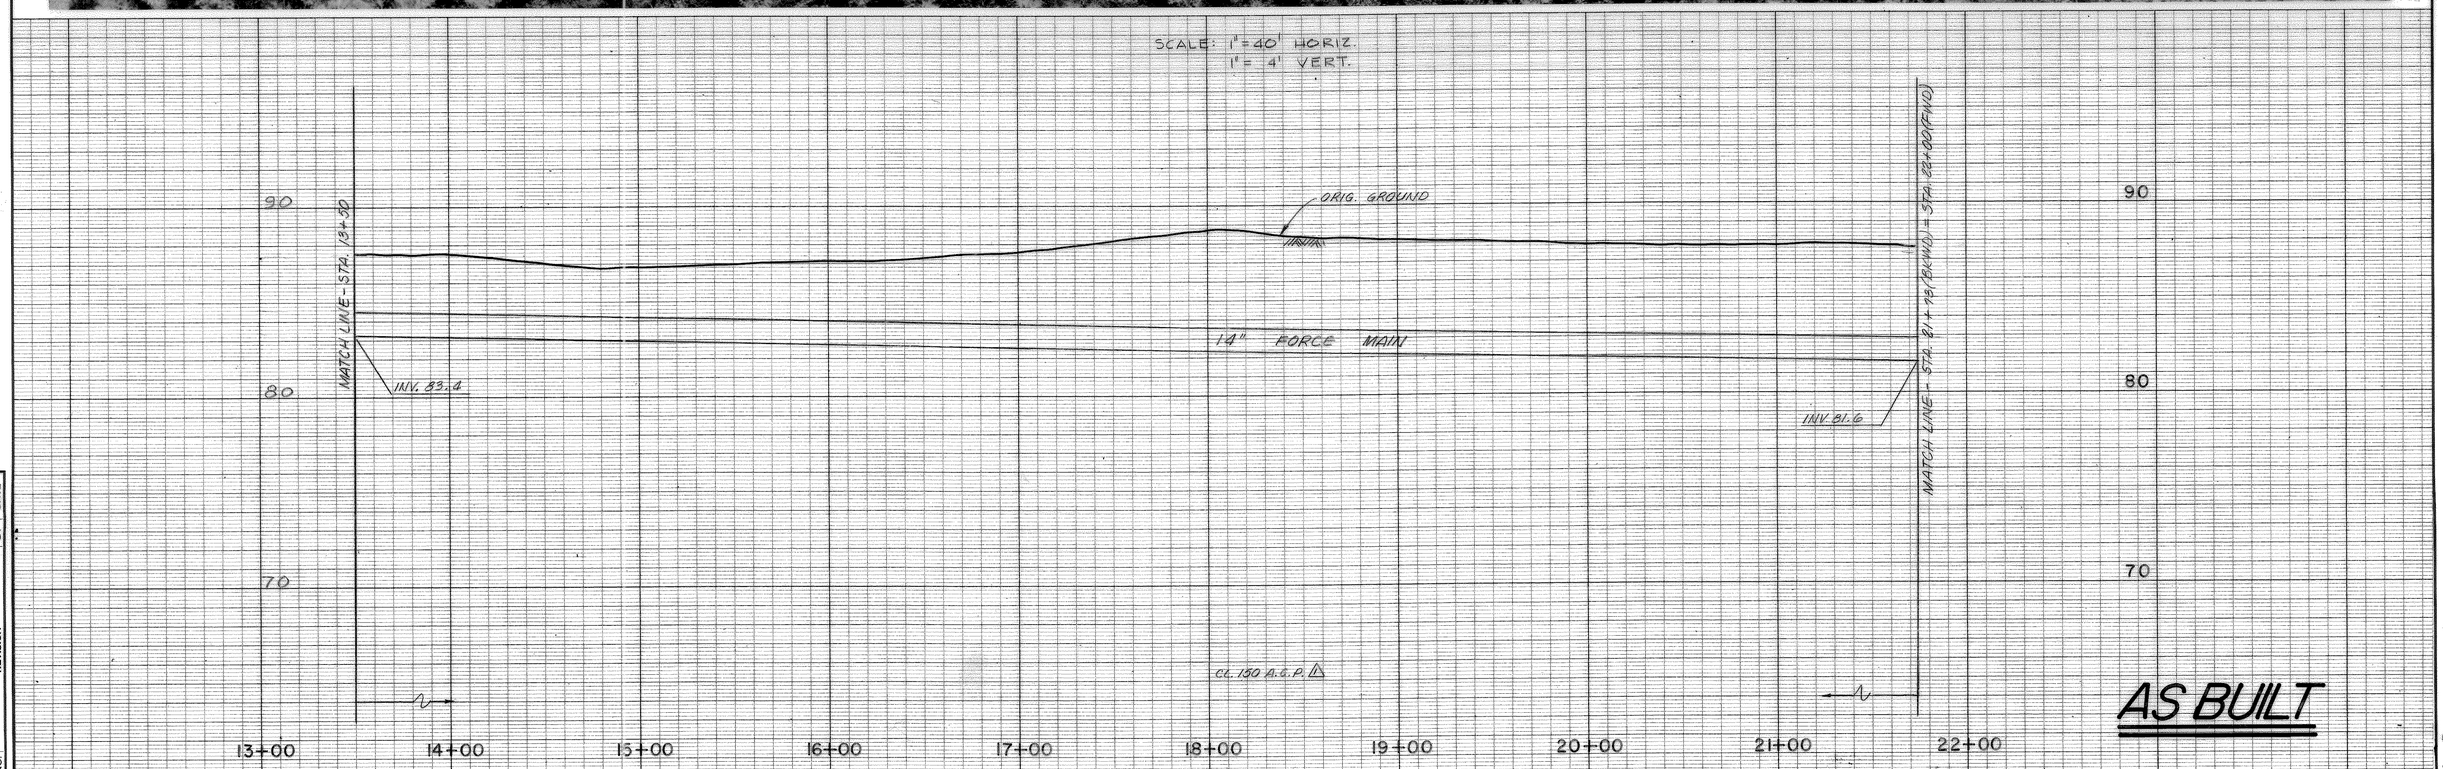

NO.	REVISION	BY	DATE
1	AS BUILT	RE	4/72
2	ADDENDUM NO. 3	EM	5/70

YODER/ORLOB ASSOCIATES
CONSULTING ENGINEERS
WALNUT CREEK, CALIFORNIA

DESIGNED M E B
DRAWN D R L
CHECKED E. M.

JOB. NO. 6305.2
DATE MARCH 1970

CITY OF HEALDSBURG, SONOMA COUNTY, CALIFORNIA

APPROVED Project Engineer
APPROVED R.P.E. CIVIL # 7023 For Yoder/Orlob Associates
APPROVED

WATER POLLUTION CONTROL FACILITIES
PROJECT UNIT 2 - SCHEDULE B

SANITARY FORCE MAIN
STA. 13+00 To STA. 22+00

DRAWING B-3

FILE No. D-

File No. CIP1970.02

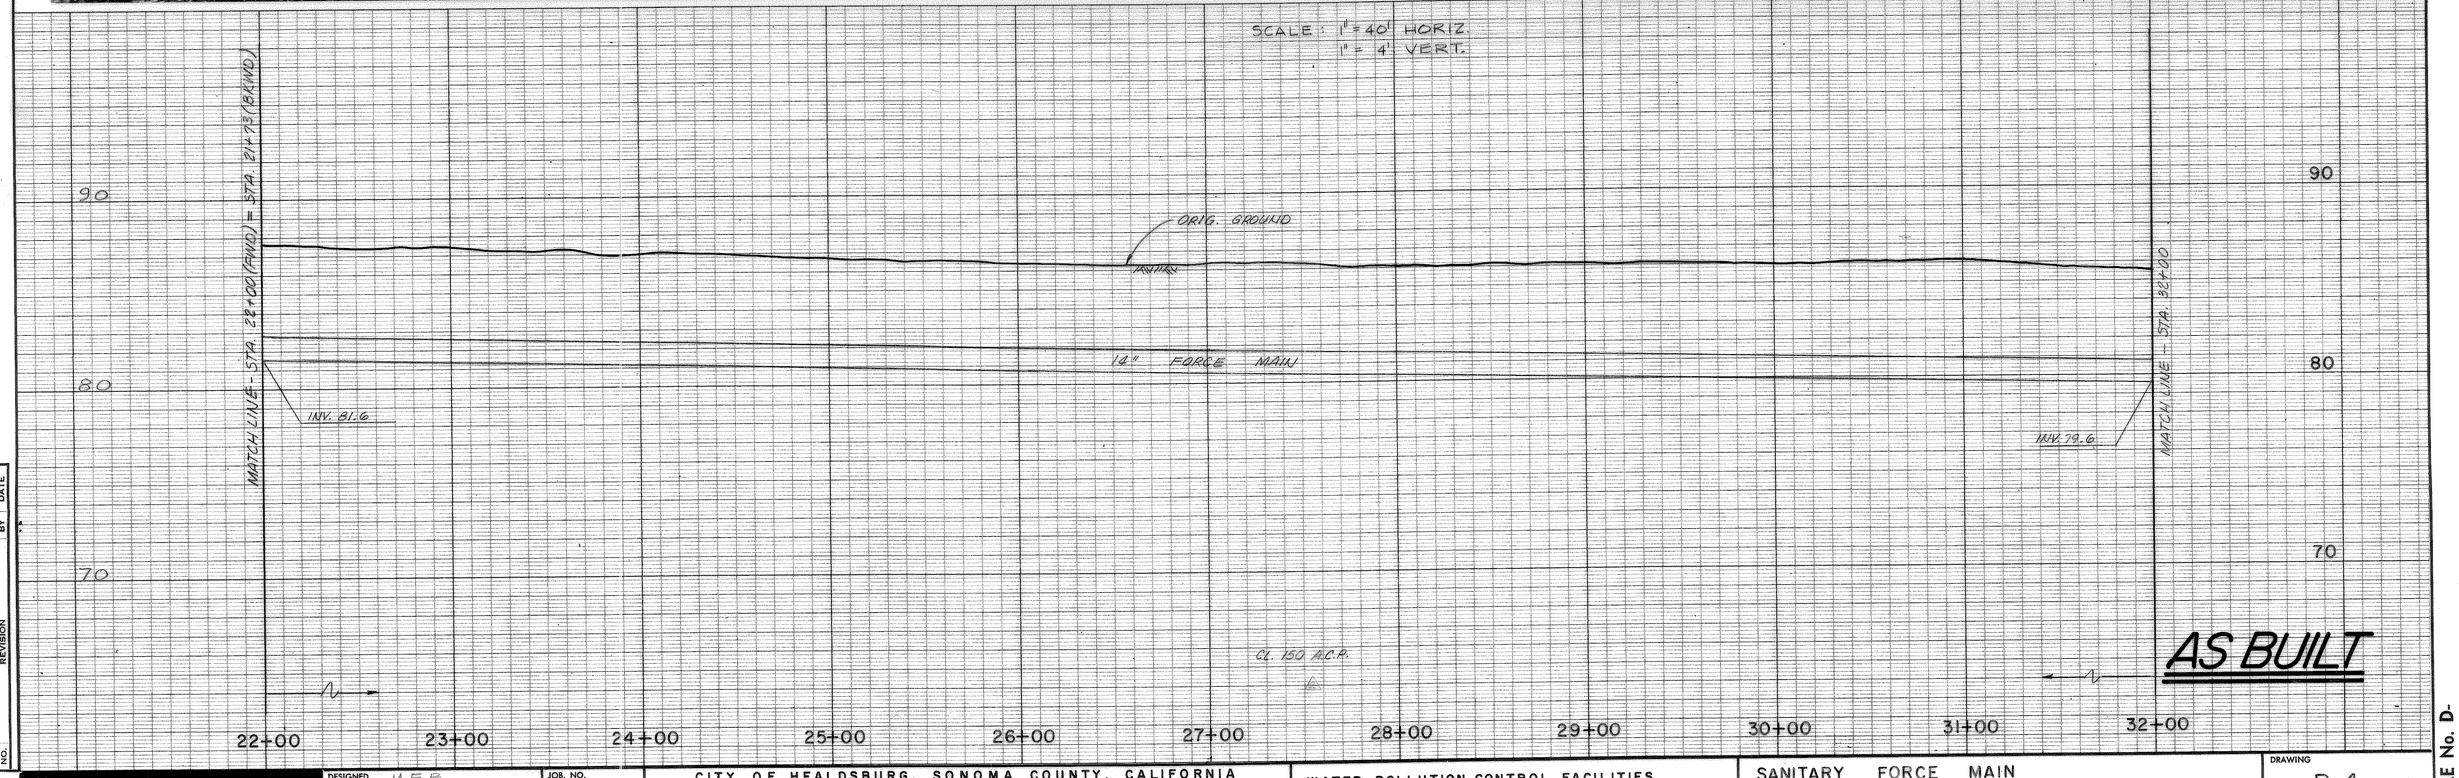

NO.	REVISION	BY	DATE
4	AS BUILT	RE	4/72
3	ADDENDUM NO. 3	EM	5/70

YODER/ORLOB ASSOCIATES
CONSULTING ENGINEERS
WALNUT CREEK, CALIFORNIA

DESIGNED MEB
DRAWN DRL
CHECKED E. M.
JOB. NO. 6305.2
DATE MARCH 1970

CITY OF HEALDSBURG, SONOMA COUNTY, CALIFORNIA

APPROVED Project Engineer
APPROVED R.P.E. CIVIL # 7023 For Yoder/Orlob Associates
APPROVED

WATER POLLUTION CONTROL FACILITIES
PROJECT UNIT 2 - SCHEDULE B

SANITARY FORCE MAIN
STA. 22+00 To STA. 32+00

DRAWING B-4

FILE No. D-

File No. CIP1970.02

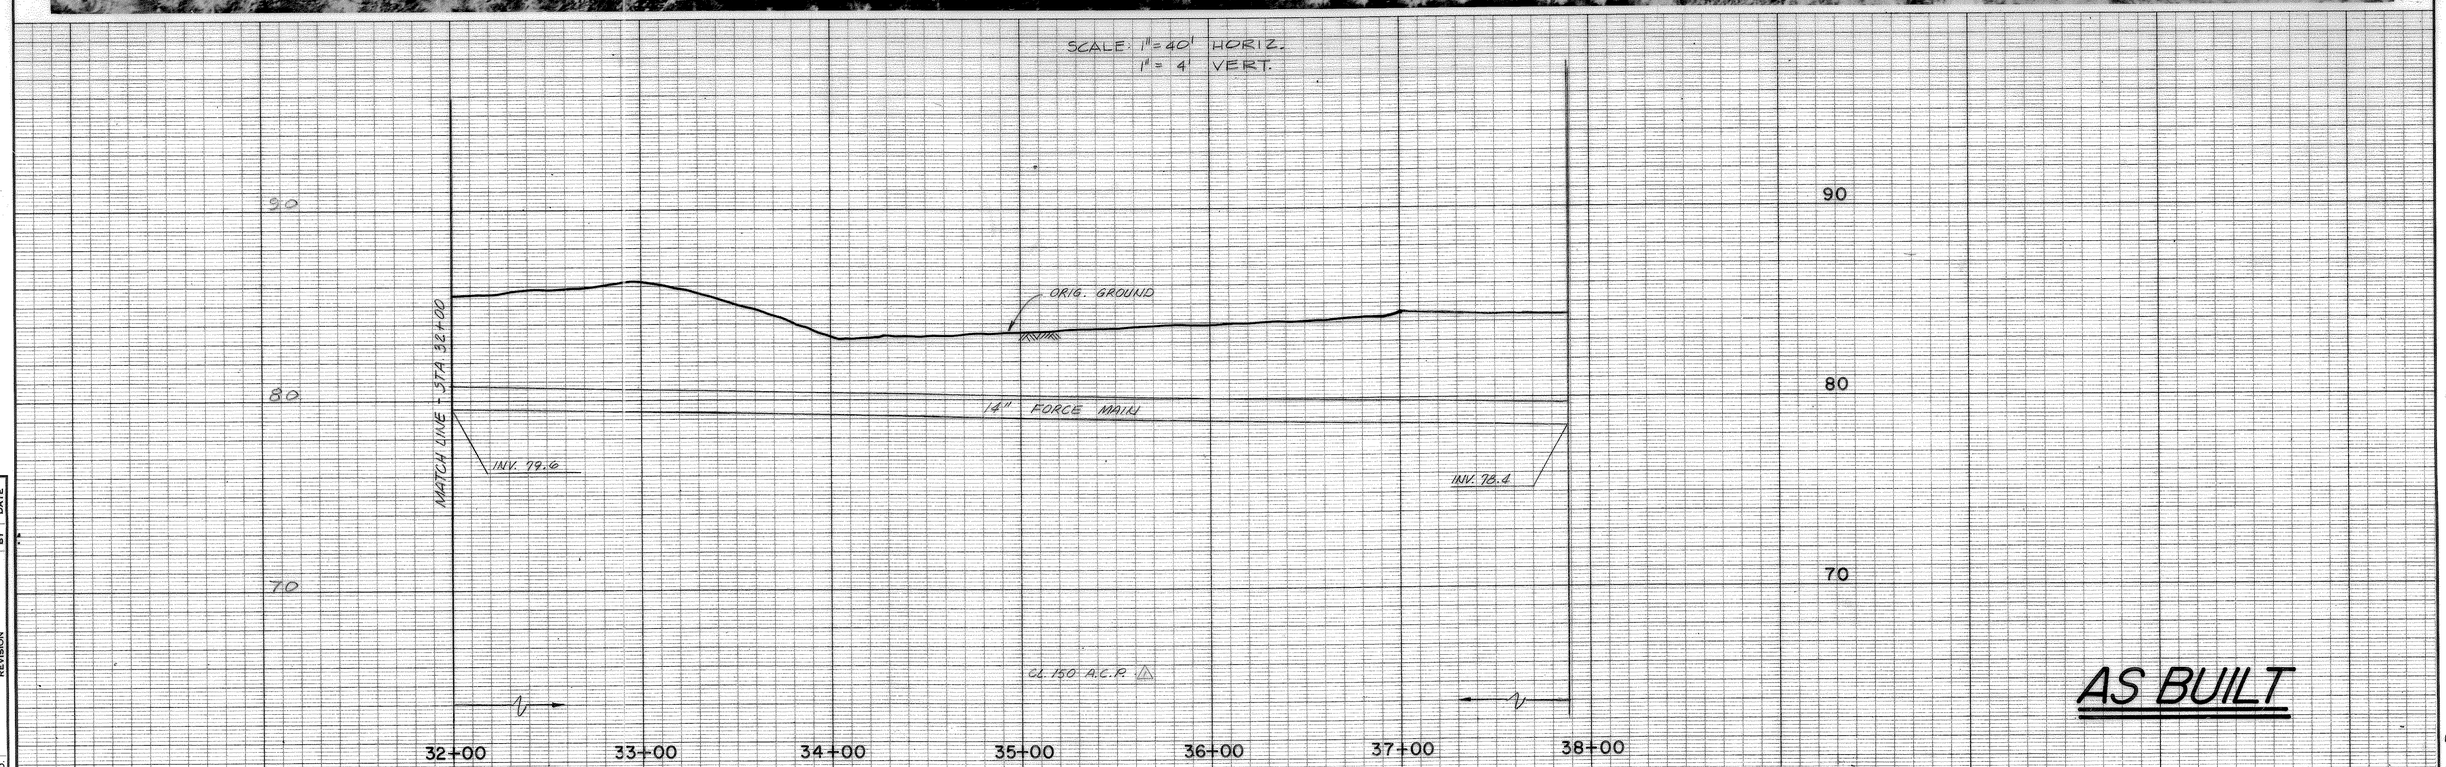

AS BUILT

NO.	REVISION	BY	DATE
1	AS BUILT ADDENDUM NO. 3	RE EM	4/72 5/70

YODER/ORLOB ASSOCIATES
CONSULTING ENGINEERS
WALNUT CREEK, CALIFORNIA

DESIGNED M E B
DRAWN D R L CHECKED E. M.

JOB. NO. 6305.2
DATE MARCH 1970

CITY OF HEALDSBURG, SONOMA COUNTY, CALIFORNIA

APPROVED Project Engineer
APPROVED R.P.E. CIVIL # 7023 For Yoder/Orlob Associates
APPROVED

WATER POLLUTION CONTROL FACILITIES
PROJECT UNIT 2 – SCHEDULE B

SANITARY FORCE MAIN
STA. 32+00 To STA. 37+92

DRAWING B-5

FILE No. D-

File No. CIP1970.02